

CONTRACT CHANGE ORDER

Change Requested by:	<input checked="" type="checkbox"/> Engineer	<input type="checkbox"/> Contractor
----------------------	--	-------------------------------------

CCO No. 10	Suppl. No. 0	Contract No. 71346	Road U.S. 50 Missouri Flat Road Interchange Phase 1C – Riparian Restoration Project	Federal Number(s) N/A
----------------------	------------------------	------------------------------	--	---------------------------------

To **Hanford ARC** ,Contractor

You are directed to make the following changes from the plans and specifications or do the following described work not included in the plans and Specifications for this contract. **NOTE: This change order must be approved by the Board of Supervisors:** Yes No

Description of work to be done, estimate of quantities and prices to be paid. (Segregate between additional work at contract price, agreed price and force account.) The last percentage shown is the net accumulated increase or decrease from the original quantity in the Engineer's Estimate

Extra Work at Agreed Lump Sum Price:

In accordance with Section 4-1.05, "Changes and Extra Work," of the Standard Specifications, and in accordance with the revised success criteria established for the riparian planting and agreed upon with the California Department of Fish and Wildlife (CDFW), furnish all labor, materials, and equipment to perform the following work:

- Prepare the riparian areas shown on Sheet 3 of this contract change order for planting. Preparation of the areas includes removal of weeds necessary for successful planting and installation of temporary irrigation.
- Plant 1-gallon plants of the species and quantities shown in Table 1:

Table 1: Replanting Species & Numbers

Common Name	Scientific Name	Qty.	General Planting Area
White alder	<i>Alnus rhombifolia</i>	5	Near creek
Douglas mugwort	<i>Artemisia douglasiana</i>	50	Any area
Santa Barbara sedge	<i>Carex barbarae</i>	225	Any area
Tufted hair grass	<i>Deschampsia caespitosa</i>	15	Any area
Interior live oak	<i>Quercus wislizeni</i>	16	Uplands, away from creek
California wild rose	<i>Rosa californica</i>	20	Uplands, away from creek
Arroyo willow	<i>Salix lasiolepis</i>	8	Near creek
CA wild grape	<i>Vitis californica</i>	9	Any area

- Include contingency planting to ensure the revised success criteria agreed upon by CDFW will be achieved.
- Extend the plant establishment period to December 31, 2023 for the additional planting in the riparian zone identified on Sheet 3 of this contract change order. All plant establishment requirements as defined in the contract specifications, including monitoring and submittal of annual monitoring reports, must be maintained for the riparian zone through December 31, 2023.
- Remove all temporary irrigation lines installed for the additional planting referenced in Table 1.
- At the end of the plant establishment period remove all irrigation lines installed for the additional planting.

For this work, the Contractor shall be compensated the agreed lump sum price of \$74,820.32. This sum constitutes full and complete compensation, for providing all labor, materials, equipment, tools, and incidentals, including all markups for this change.

Total Increase.....\$74,820.32

No Additional Text In This Section

CONTRACT CHANGE ORDER

Change Requested by:	<input checked="" type="checkbox"/> Engineer	<input type="checkbox"/> Contractor
----------------------	--	-------------------------------------

CCO No. 10	Suppl. No. 0	Contract No. 71346	Road U.S. 50 Missouri Flat Road Interchange Phase 1C – Riparian Restoration Project	Federal Number(s) N/A
----------------------	------------------------	------------------------------	--	---------------------------------

No Additional Text In This Section

Estimated Cost: Decrease Increase **\$74,820.32**

By reason of this order the time of completion will be adjusted as follows: **No Adjustment**

Submitted by

SIGNATURE Aradhana Kochar	Digitally signed by Aradhana Kochar Date: 2021.05.26 09:46:06 -0700'	(PRINT NAME & TITLE) Aradhana Kochar, P.E., Resident Engineer	DATE 5/26/2021
---------------------------------	---	--	-------------------

Approved

SIGNATURE John Kahling	Digitally signed by John Kahling DN: cn=John Kahling, o=Dorado County, Department of Transportation, ou=Headington Engineering Unit, email=john.kahling@dorado.ca.us c=US Date: 2021.06.01 15:27:39 -0700'	(PRINT NAME & TITLE) John Kahling, P.E., Deputy Director, Engineering	DATE 06/01/21
---------------------------	--	--	------------------

Approved


SIGNATURE 	(PRINT NAME & TITLE) Rafael Martinez, Director Transportation Department, Community Development Services	DATE 6/3/21
--	---	----------------

Approved

SIGNATURE	(PRINT NAME & TITLE) John Hidahl, Chair Board of Supervisors	DATE
-----------	--	------

We the undersigned contractor, have given careful consideration to the change proposed and agree, if this proposal is approved, that we will provide all equipment, furnish the materials, except as may otherwise be noted above, and perform all services necessary for the work above specified, and will accept as full payment therefor the prices shown above. The prices and terms of payment shown above comprise full and final compensation for all direct costs, indirect costs, cumulative costs, and all overhead costs incurred as a result of this contract change order. NOTE: If you, the contractor, do not sign acceptance of this order, your attention is directed to the requirements of the specification as to proceeding with the ordered work and filing a written protest within the time therein specified.

Contractor Acceptance by

SIGNATURE 	(PRINT NAME & TITLE) Asha Virlovvet, Project Manager	DATE 5/18/21
--	---	-----------------

**CONTRACT CHANGE ORDER 10
SHEET 3 OF 3**

Dist	COUNTY	ROUTE	POST MILES TOTAL PROJECT	SHEET No.	TOTAL SHEETS
03	ED	50	14.2/15.6	16	24

Kristin Lantz
LICENSED LANDSCAPE ARCHITECT

March 11, 2016
PLANS APPROVAL DATE


THE STATE OF CALIFORNIA OR ITS OFFICERS OR AGENTS SHALL NOT BE RESPONSIBLE FOR THE ACCURACY OR COMPLETENESS OF SCANNED COPIES OF THIS PLAN SHEET.

ICF INTERNATIONAL
630 K STREET
SUITE 400
SAC, CA 95814

LICENSED LANDSCAPE ARCHITECT
Kristin Lantz
12/31/2016
03/11/2016
STATE OF CALIFORNIA

NOTE:

FOR ACCURATE RIGHT OF WAY DATA, CONTACT RIGHT OF WAY ENGINEERING AT THE DISTRICT OFFICE.

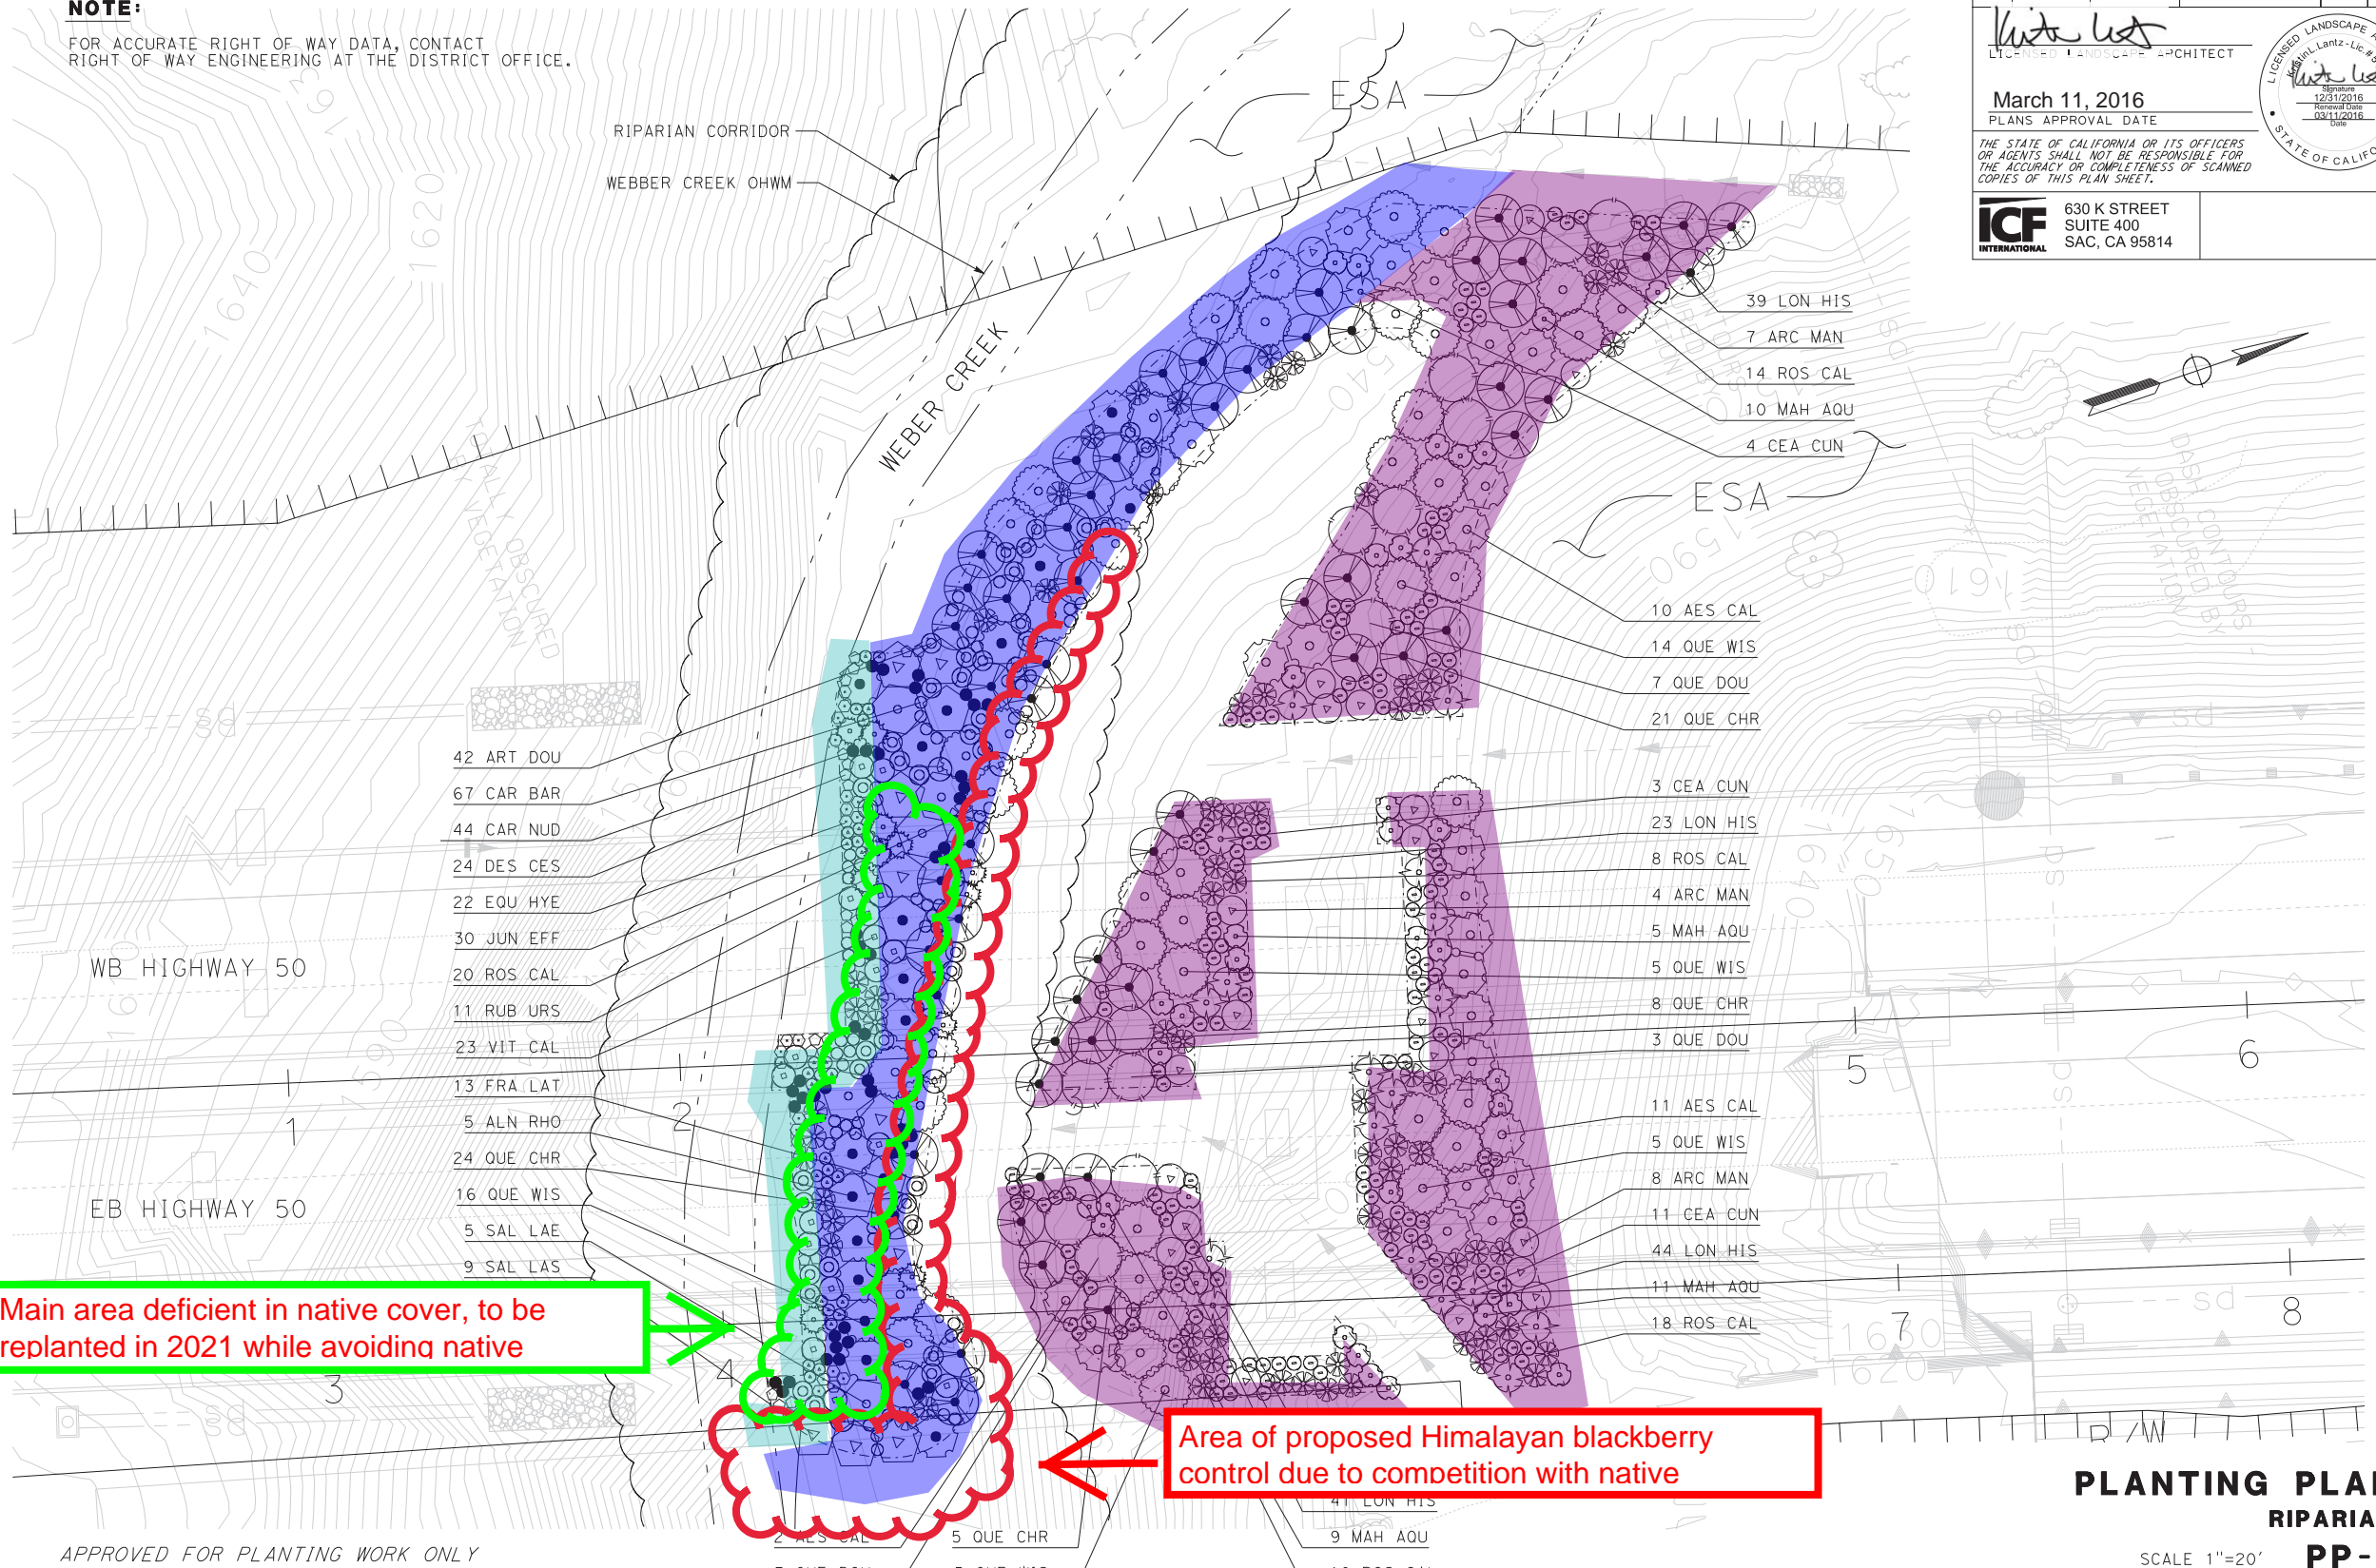

- 42 ART DOU
- 67 CAR BAR
- 44 CAR NUD
- 24 DES CES
- 22 EQU HYE
- 30 JUN EFF
- 20 ROS CAL
- 11 RUB URS
- 23 VIT CAL
- 13 FRA LAT
- 5 ALN RHO
- 24 QUE CHR
- 16 QUE WIS
- 5 SAL LAE
- 9 SAL LAS

- 39 LON HIS
- 7 ARC MAN
- 14 ROS CAL
- 10 MAH AQU
- 4 CEA CUN

- 10 AES CAL
- 14 QUE WIS
- 7 QUE DOU
- 21 QUE CHR

- 3 CEA CUN
- 23 LON HIS
- 8 ROS CAL
- 4 ARC MAN
- 5 MAH AQU
- 5 QUE WIS
- 8 QUE CHR
- 3 QUE DOU

- 11 AES CAL
- 5 QUE WIS
- 8 ARC MAN
- 11 CEA CUN
- 44 LON HIS
- 11 MAH AQU
- 18 ROS CAL

Main area deficient in native cover, to be replanted in 2021 while avoiding native

Area of proposed Himalayan blackberry control due to competition with native

APPROVED FOR PLANTING WORK ONLY

**PLANTING PLAN
RIPARIAN
PP-6**

SCALE 1"=20'

LAST REVISION: DATE PLOTTED => 3/9/2016 TIME PLOTTED => 3:01:28 PM