

COMMUNITY DEVELOPMENT SERVICES

PLANNING AND BUILDING DEPARTMENT

http://www.edcgov.us/DevServices/

PLACERVILLE OFFICE:

2850 Fairlane Court, Placerville, CA 95667 BUILDING

(530) 621-5315 / (530) 622-1708 Fax bldgdept@edcgov.us

PLANNING

(530) 621-5355 / (530) 642-0508 Fax

planning@edcgov.us

LAKE TAHOE OFFICE:

924 B Emerald Bay Rd South Lake Tahoe, CA 96150 (530) 573-3330

(530) 542-9082 Fax

TO:

County of El Dorado Agricultural Commissioner/Commission

FROM:

Mark Millard, Senior Planner

DATE:

August 06, 2018

RE:

ADM18-0183/James and Amy Fox

Administrative Relief from Agricultural Setback

Assessor's Parcel Number: 087-021-32

Planning Request and Project Description:

Planning Services is requesting review for administrative relief from the agricultural setback for the above referenced project. This request is for the construction of a single family dwelling unit (Building Permit Application Nos. 300123, & 300126). According to the applicant, the proposed building site is approximately seventy-nine feet, four inches (79'4") from the property line of the adjacent Limited Agriculture-40 acre zoned parcel (LA-40) to the north (APN: 046-021-35). The applicant's parcel, identified by APN 087-021-32 consists of 20.609 acres and is located at 2990 White Thorn Road. (Supervisor District: 2).

Note: Applicant's request stated a relief request of a total of approximately 121feet (Required 200 foot setback minus the proposed 79.34-foot building setback from the property line).



COMMUNITY DEVELOPMENT SERVICES PLANNING AND BUILDING DEPARTMENT

2850 Fairlane Court, Placerville, CA 95667

Phone: (530) 621-5355 www.edcgov.us/Planning/

APPLICATION FO	R: <u>ADMINISTRAT</u>	IVE PERMIT	FILE #_ADM 8-0 83
ASSESSOR'S PARCE	LNO.(s) 087-0	021-32-10	0
PROJECT NAME/REG	QUEST: (Describe proposed use	Residentic	il Dwelling
		,	d
,	Tames and	/ C E.	
APPLICANT/AGENT		I Umay tox	Plant with CREEK
Mailing Add	P.O. Box or Street	ecasid Trail	Placervilles (a=95667
Phone (91		9 EMAIL: JF	OX. AFOX WOMAIL. CO
PROPERTY OWNER	James and	amy fox	<u>ρ</u> Π ώ
Mailing Add		0	PH PAR
	P.O. Box or Street	City	State & Zip
Phone () ROPERTY OWNERS ON SEPAR	EMAIL:	02 02
ENGINEER/ARCHITE	11:00	Towna .	
Mailing Add	11		d. Shingle Springs, (a 956
_	P.O. Box or Street	-	,
Phone (53	30, 391 616	EMAIL: NICO	le young De Qya hoo. co
LOCATION: The prop	perty is located on the	35+side of	south shingle rd.
0.7 f		N/E/W/S of the intersection with White	te thorn rd/south shing, major street or foad
in the $5h$	ingle springs		
	199		acreage / square footage
x My to	nature of property owner or auti	Date	7-3-18
FOR OFFICE USE ONLY			
Date 7.3.18		Receipt #_ 127193 Re	Mala i a
The second secon			ec'd by Mlow Census
Zoning (A=40)	GPDSuperviso	r DistSec	TwnRng
ACTION BY:	DIRECTOR	ZONING	S ADMINISTRATOR
		Hearing Date	
Approved	Denied /or conditions attached	Approve	edDenied Findings and/or conditions attached
rindings and,	or conditions attached		Findings and/or conditions attached
Title		APPEAL: Approve	edDenied
11110			



DEPARTMENT OF AGRICULTURE WEIGHTS AND MEASURES

Juli Jensen Agricultural Commissioner Sealer of Weights and Measures

311 Fair Lane Placerville, CA 95667 (530) 621-5520 (530) 626-4756 FAX eldcag@edcgov.us


REQUEST FOR ADMINISTRATIVE RELIEF FROM AN AGRICULTURAL SETBACK – APPLICATION

APPLICANT(S) NAME(S): Tames and Amy Fox
SITE ADDRESS: 2990 White Thorn Rd. Shingle Springs, Ca 9568
MAILING ADDRESS: 128/ Muccasin Trail Placerville, Ca 95667
TELEPHONE NUMBER(S): (DAY) 9168042789 (EVE) 916804 3565
APN#: 087-021-32-100 PARCEL SIZE: 20.6 GCTPS ZONING: LA.40
LOCATED WITHIN AN AG DISTRICT? YES NO ADJACENT PARCEL ZONING: agriculturg
IF THE ADJACENT PARCEL IS ZONED TPZ OR NATURAL RESOURCES, IS YOUR PROPERTY LOCATED WITHIN A COMMUNITY REGION OR RURAL CENTER? YES NO NOT APPLICABLE
REQUIRED AG SETBACK: 200 foot SETBACK YOU ARE REQUESTING: Toot
REQUESTED USE (AGRICULTURALLY-INCOMPATIBLE): 125/dential home
set@ 79.4 feet from property line
Do You Have A Building Permit For Requested Use? YES (Permit \$\overline{9300 23}) NO
PLEASE ANSWER THE FOLLOWING:
1 YES NO Does a natural barrier exist that reduces the need for a setback? (A Topography & Other Tence, trees, top of hill
2. YES NO Is there any other suitable building site that exists on the parcel except within the required setback?
3. YES (NO) Is your proposed agriculturally-incompatible use located on the property to administ any potential negative impact on the adjacent agricultural lands.
4. List any site characteristics of your purcel and the adjuscent agricultural land that the Agricultural Commission should consider (including, but not limited to, topography, vegetation, and location of agricultural improvements, etc.):
A utility easement is in place. Minimal grading required on flattest area
on property. Proximity to power and water is officient. Natural rock outcroppings
will enhance value of land due to the long range wirws. Other building site reserved for fire department access point.

IN THE DIAGRAM BELOW, S	SHOW THE FOLLOWING:
-------------------------	---------------------

- A.
- B.
- C.
- D.
- AM BELOW, SHOW THE FOLLOWING:
 Zoning of your parcel
 Zoning of adjacent parcels
 Placement of agriculturally-incompatible use
 Indicate requested setback distance
 Indicate any unique site characteristics of property E.

	APPLICANT'S PARCEL	
ANY ADDITIONAL COMMENTS?		
Applicant's Signature	<u></u>	7-2-18 Date
OFFICE USE ONLY:	Receipt #:	Initials:

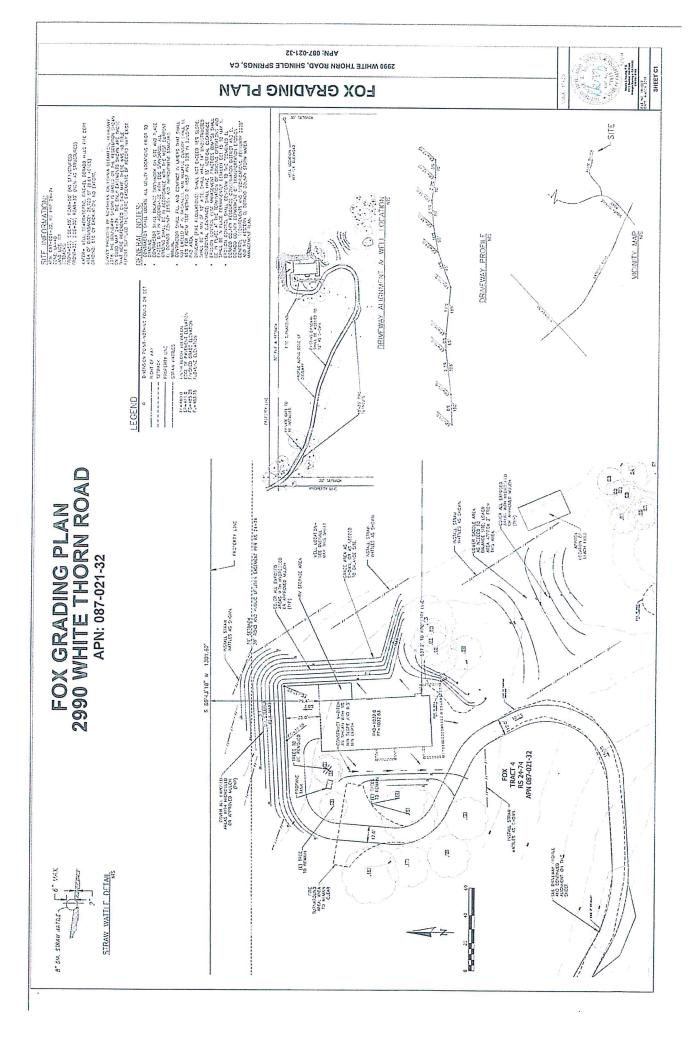

Planning Services

Home > Government > Planning

PARCEL DATA INFORMATION

7/3/2018 Enter Another Parcel

Assessor's Parcel Number: 087-021-32

PROPERTY INFORMATION:

-										
STATUS				JURISDICTION		TAX	RATE	MAP	ACREAGE	
		ESSMENT ROL			COUNTY OF EL DORADO		76	5 - 7 F	RS 24/74/4	20.609
2015	GENE	RAL PLAN LA	ND USE INFO	RMATION:						
DES DIST. PRESERVES COPPIDOR RESOURCES LANDS REGIONS CENTERS PLANS PLA							ADOPTED PLAN NAME			
RR										
2015 2	2015 ZONING INFORMATION:									
ZOI	NING	DESIGNATION	DESIGN	CONTROL	DI ANNIE	D DEVEL	ODM	ENT [OTHER	VEDI AVO
LA-40		CONTINUE	ILAMAL	DULVEL	OPIVI	EIVI	OTHER O	VERLAYS		
2004	2004 GENERAL PLAN LAND USE INFORMATION:									
-										
USE DES.	AG		IMPORTANT BIOLOGICAL CORRIDOR	MINERAL RESOURCES	PLATTED LANDS	COMMUN REGION		RURAL		ADOPTED PLAN NAME
RR										TAZANIE
2004 Z	2004 ZONING INFORMATION:									
ZONING DESIGNATION DESIGN CONTROL DIAMMED DESIGN CONTROL										
						D DEL				

ZONING DESIGNATION	DESIGN CONTROL	PLANNED DEVELOPMENT	OTHER OVERLAYS
RA-40			
DISTRICTS	1		

CSD	SCHOOL	WATER
	LATROBE	UNASSIGNED
		CSD SCHOOL LATROBE

FLOOD ZONE INFORMATION (See Note below):


FIRM PANEL NUMBER REVISION	R & PANEL REVISION DATE	FLOOD ZONE	FLOOD ZONE BUFFER	FLOODWAY
06017C0975E	09/26/2008	X		

MISCELLANEOUS DATA:

2 SHIVA FRENTZEN			No
SUPERVISORIAL DISTRICT	AG PRESERVE	RARE PLANT MITIGATION AREA	MISSOURI FLAT MC&FP

No Eligibility Review Required

NOTE: The flood zone information presented here is based solely on data derived from the FEMA Flood Information Rate Maps, and does not include data from any other flood studies.

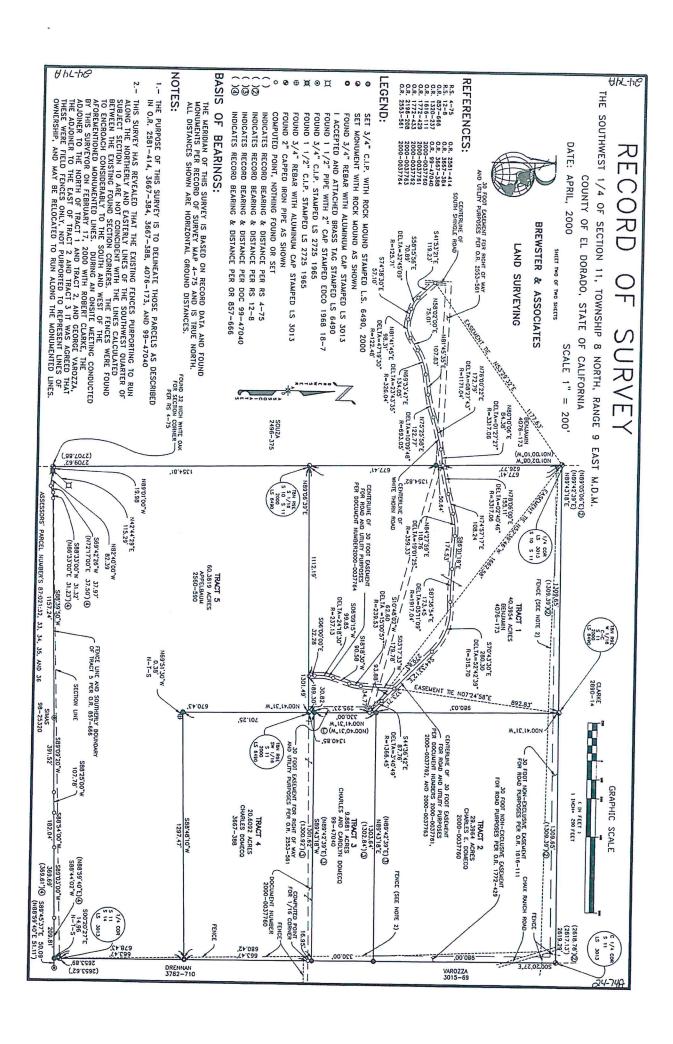



RECORD SURVEY

THE SOUTHWEST 1/4 OF SECTION 11, TOWNSHIP 8 NORTH, RANGE 9 EAST M.D.M. DATE: APRIL, 2000 COUNTY OF EL DORADO, STATE OF CALIFORNIA SCALE 1" = 400'

SHEET ONE OF TWO SHEETS



BREWSTER & ASSOCIATES

LAND SURVEYING


SURVEYOR'S STATEMENT:

THIS MAP CORRECTLY REPRESENTS A SURVEY MADE BY ME OR UNDER MY DIRECTION IN CONFORMANCE WITH THE REQUIREMENTS OF THE LAND SURVEYORS' ACT AT THE REQUEST OF GEORGE D. AND LYNETTE APPELBAUM, JAMES L. AND CHERYL R. BENJAMIN,

MARCH 2000

AND CHARLES E. AND CAROLYN M. DOMECO IN

PETER S. BREWSTER, P.L.S. 6490 LICENSE EXPIRATION DATE 6-30-03

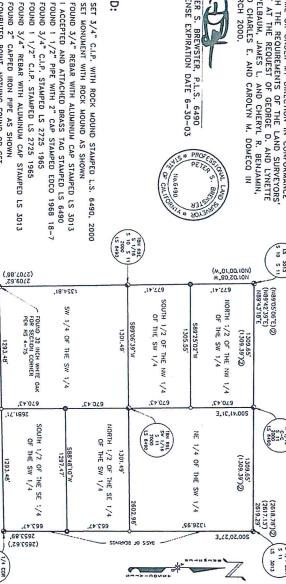

LEGEND:

X • **X**

COUNTY SURVEYOR'S STATEMENT:

THIS MAP HAS BEEN EXAMINED IN ACCORDANCE WITH SECTION 8766 OF THE LAND SURVEYORS' ACT THIS DAY OF ANGUST., 2000.

DAZIEL

RUSSELL

DANIEL S. RUSSELL, P.L.S. 5017
COUNTY SURVEYOR
COUNTY OF EL DORADO
LICENSE EXPIRATION DATE 12-31-01 ASSOCIATE LAND SURVEYOR RICHARD L. BRINER P.L.S. 5084 LICENSE EXPIRATION DATE 6-30-03

RECORDER'S STATEMENT:

AT THE REQUEST OF GEORGE D. AND LYNETTE APPELBAUM, JAMES L. AND CHERYL R. BENJAMIN, AND CHARLES E. AND CAROLYN M. DOMECO. FILED THIS 3 DAY OF (LUQUAL , 2000 AT 9 :: CR: 58 IN BOOK 24 OF RECORD OF SURVEYS AT PAGE 74 ...

DOCUMENT NUMBER 200-0038705

WILLIAM E. SCHULTZ
WILLIAM E. SCHULTZ
COUNTY RECORDER, CLERK
COUNTY OF EL DORADO BY:

トレートで

INDICATES RECORD BEARING & DISTANCE PER DOC 99-47040 INDICATES RECORD BEARING & DISTANCE PER OR 857-666 INDICATES RECORD BEARING & DISTANCE PER RS 4-75
INDICATES RECORD BEARING & DISTANCE PER RS 12-8

TOWNSHIP 8 NORTH, RANGE 9 EAST M.D.M.

SSFSSORS' PARCEL HUMBER'S 87:021:32, 33, 34, 35, AND 36

extitionite

+0

1 SPRECTION

んこうしていいいい

14.14.200

1 INCH= 400 FEET GRAPHIC SCALE BREAKDOWN OF THE SOUTHWEST

ONE QUARTER OF SECTION 11

COMPUTED POINT, NOTHING FOUND OR SET FOUND 2" CAPPED IRON PIPE AS SHOWN

FOUND 3/4" REBAR WITH ALUMINUM CAP STAMPED LS 3013

FOUND 1 1/2" C.I.P. STAMPED LS 2725 1965 FOUND 3/4" C.I.P. STAMPED LS 2725 1965

ACCEPTED AND ATTACHED BRASS TAG STAMPED LS 6490

® 24-74

24-74